

SCHEDULE OF PLOTS

TYPE	SIZE OF PLOTS	AREA IN SQ.MT.	NOS	SET BACKS		
				FRONT	SIDE	REAR
E	80.00X50.00 M.	4000	3	12.0	6.0	6.0
F	65.00X35.00 M.	1950	18	6.0	3.0	3.0
H	25.00X20.00 M.	500	24	4.0	3.0	2.0
	SPECIAL	---	2			
TOTAL			37			

LAND USE

AREA UNDER SCHEME	58.44 ACRES
- PLOTS	= 33.34
- ROAD	= 8.37
- OPEN	= 0.27
- COMMERCIAL SHOPS	= 0.20
- WATER SUPPLY	= 0.29
- SERVICES	= 2.50
- DHABA CMPLX	= 1.09
- EXT. BONE FACTORY	= 3.75
- EXT. MILK CHILLING PLANT	= 8.75
TOTAL	= 58.44 ACRES

DETAIL OF SHOPS

S. NO.	TYPE	SIZE IN MTRS	SIZE IN MTRS	AREA IN SQ. MTRS	NOS
1	S	3.0X8.0M	1.5 M WIDE	22.50 SQ.M	20
2	S1	3.0X4.50M	..	13.50 ..	20

DETAIL OF SHOPS REF. DRG. NO. IP/741/79

NOTE:-

- PLOT NO. 33, 15 DELETED FROM THE PLAN
- THIS DRAWING SUPERSEED ALL PREVIOUS DRAWINGS
NO. IP/341/64,386/65, 389/ 85 & 338/ 84

REVISED PORTION SHOWN IN RED

THE SET BACKS OF PLOTS NO SP - 34 HAS BEEN APPROVED
VIDE LETTER NO. IP/ ARCH/ SWM/ 721 DT. 02-05-86

REVISED LAYOUT PLAN OF INDUSTRIAL AREA RANTHAMBOR,SAWAIMADHOPUR (RAJ.)


SCALE - NTS DRG.NO. IP/492/87 DT. 21-04-1987

DEALT BY:-

(V.P.GAUTAM)
SR. DRAUGHTS MAN

(B.S.PARIHAR)
SR. PLANNING ASST

(J.K. MITTAL)
Dy. TOWN PLANNER

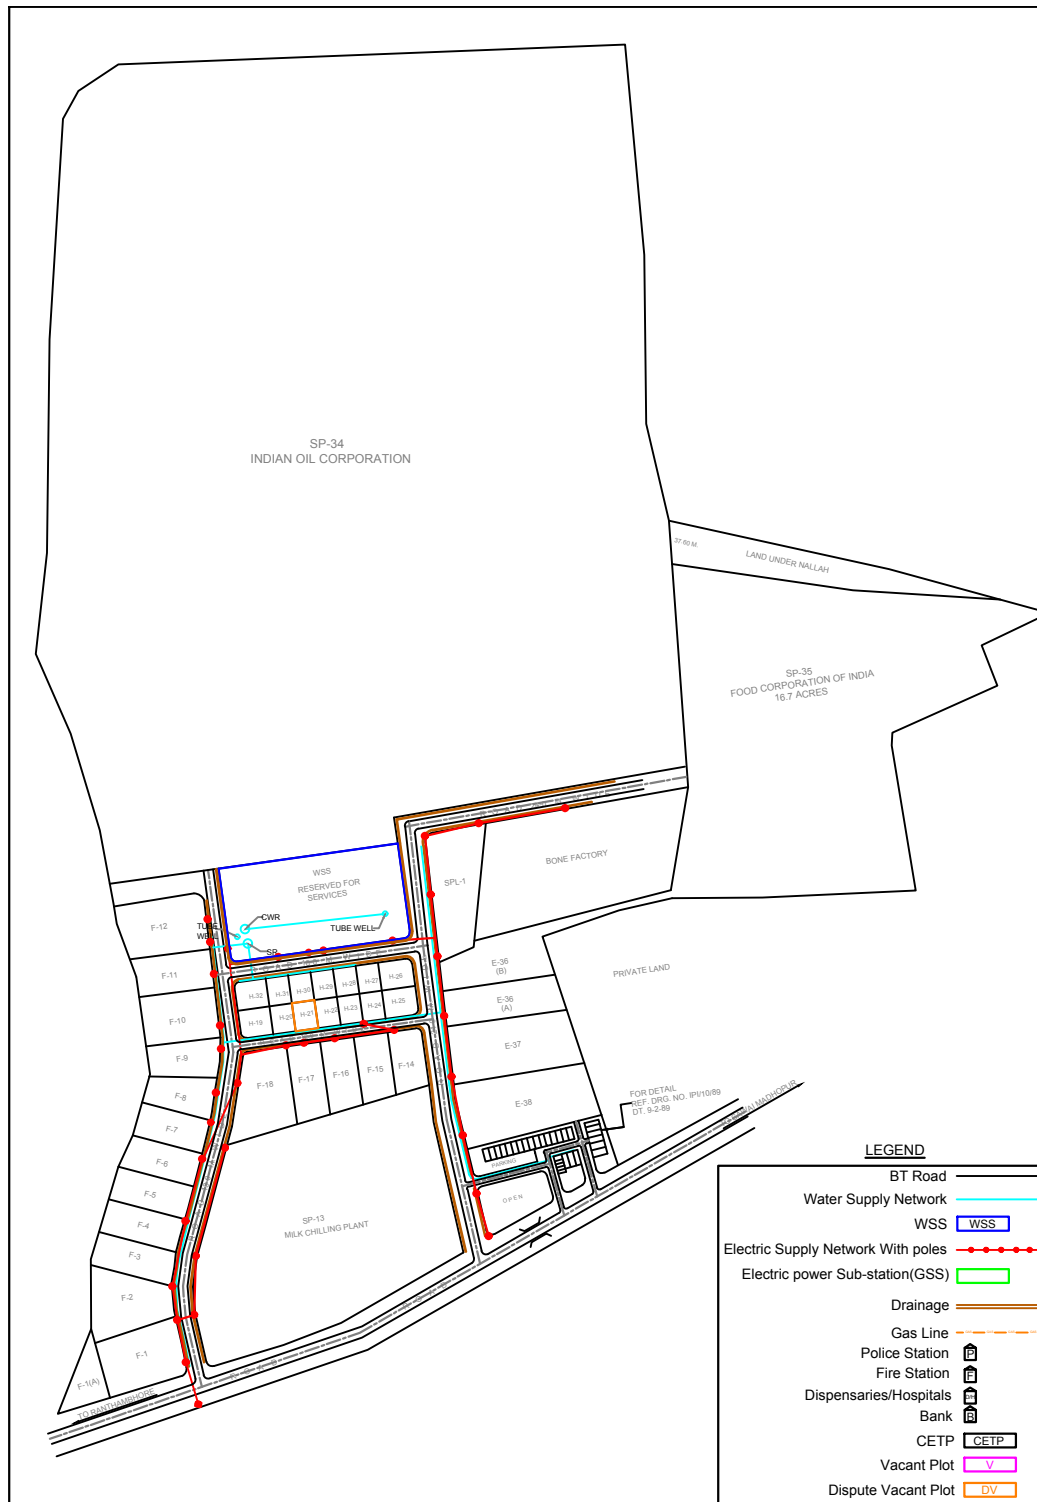

LEGEND

BT Road	
Water Supply Network	
WSS	
Electric Supply Network With poles	
Electric power Sub-station(GSS)	
Drainage	
Gas Line	
Police Station	
Fire Station	
Dispensaries/Hospitals	
Bank	
CETP	
Vacant Plot	
Dispute Vacant Plot	